

8/16/2021

# **ADDENDUM 1**

# T-2021-78 CEC - BAS, VAV, Reheat Coils & Exhaust Fans Replacement Project

# Revised CLOSING date: August 23, 2021 @2:00PM

# To follow are:

- Questions & Answers
- Addendum ME-01

## Question 1:

The tender document states a cash allowance of \$15,000.00 is to be carried for air balancing while the form of tender states a total cash allowance of \$10,000.00. Please advise.

# Answer 1: A CASH ALLOWANCE OF \$15,000.00 SHALL BE CARRIED FOR AIR BALANCING, OWNER/CONSULTANT WILL PICK THE AIR BALANCING COMPANY AND PROVIDE DIRECTIONS TO THE AIR BALANCER DIRECTLY.

## Question 2:

As per PART 2 – SCOPE OF WORK: Contractor to follow instructions provided by the Board's Asbestos Abatement Consultant attached with the tender documents, BUT there is no DSS report attached. Please advise if the Asbestos Abatement is to be included in the base bid price.

Answer 2: ASBESTOS ABATEMENT SHALL BE INCLUDED IN THE BASE BID PRICE.

August 13, 2021

CEC – BAS, VAV, Reheat Coils & Exhaust Fans Replacement Project

REGAL CONSULTING ENGINEERS INC. 2359 Royal Windsor Drive, Suite 201 Mississauga, ON L5J 4S9 Phone: 905-855-3010

This addendum forms part of the contract documents and amends the original bidding requirements, drawings and specifications, as noted below.

#### ARCHITECTURAL

#### 1. Phasing of the project:

### a) Phase 1 – Third Floor

General Contractor shall start demolition and new work at the third floor as phase 1 of the project, General Contractor shall provide a construction schedule for the phase to get approval from the owner/consultants before starting of any work at CEC. Refer to the mechanical drawings for the details for each floor.

### b) Phase 2 – Second Floor

General Contractor shall proceed to phase 2 upon completion of phase 1, a detailed construction schedule shall be provided for phase 2 and submitted to get approval from the owner/consultants before starting of any work at the second floor of CEC.

#### c) Phase 3 – Main Floor

General Contractor shall proceed to phase 3 upon completion of phase 2, a detailed construction schedule shall be provided for phase 3 and submitted to get approval from the owner/consultants before starting any work at the main floor of CEC.

#### d) Phase 4 – Lower-Level Floor

General Contractor shall proceed to phase 4 upon completion of phase 3, a detailed construction schedule shall be provided for phase 4 and submitted to get approval from the owner/consultants before starting any work at the lower level of CEC.

#### **MECHANICAL:**

#### **MECHANICAL SPECIFICATIONS:**

Specs section 15510 Hydronic Piping:

Sub section 2.2: Hydronic piping shall be strictly based on the specifications provided,

Any rubber coupling or slip-on fittings will not be allowed.

Mechanical contractor shall allow for providing and installing balancing dampers model (Nailor 1890) steel butterfly round duct dampers for 12" diameter round duct.

Allow for providing and installation of 80 each of Nailor 1890 manual 12" round duct balancing dampers.

#### ADDENDUM ME-1

August 13, 2021

CEC – BAS, VAV, Reheat Coils & Exhaust Fans Replacement Project

REGAL CONSULTING ENGINEERS INC. 2359 Royal Windsor Drive, Suite 201 Mississauga, ON L5J 4S9 Phone: 905-855-3010

This addendum forms part of the contract documents and amends the original bidding requirements, drawings and specifications, as noted below.

# Existing balancing dampers not in good condition shall be replaced with the new Nailor 1890 steel butterfly manual balancing dampers, exact location and size of the manual balancing damper will be determined on site.

#### **BAS VENDOR FOR CEC PROJECT:**

BAS Vendor is Reliable/Set point Automation ONLY.

VAV BOXES WITH REHEAT COILS: METALAIRE VAV BOXES WITH REHEAT COILS SHALL BE TREATED AS EQUAL TO E.H. PRICE. (BASIS OF DESIGN).


#### MECHANICAL

- 1. Find attached mechanical sketches M1.0-A-1 with changes as shown clouded.
- 2. Find attached mechanical sketch M2.0D-A-1 with changes as shown clouded.
- 3. Find attached mechanical sketch M2.3D-A-1 with changes as shown clouded.

#### ELECTRICAL

- **4.** Find attached electrical drawings E1.0.
- 5. Find attached electrical drawings E2.0.
- **6.** Find attached electrical drawings E3.0.

END OF ADDENDUM ME-1

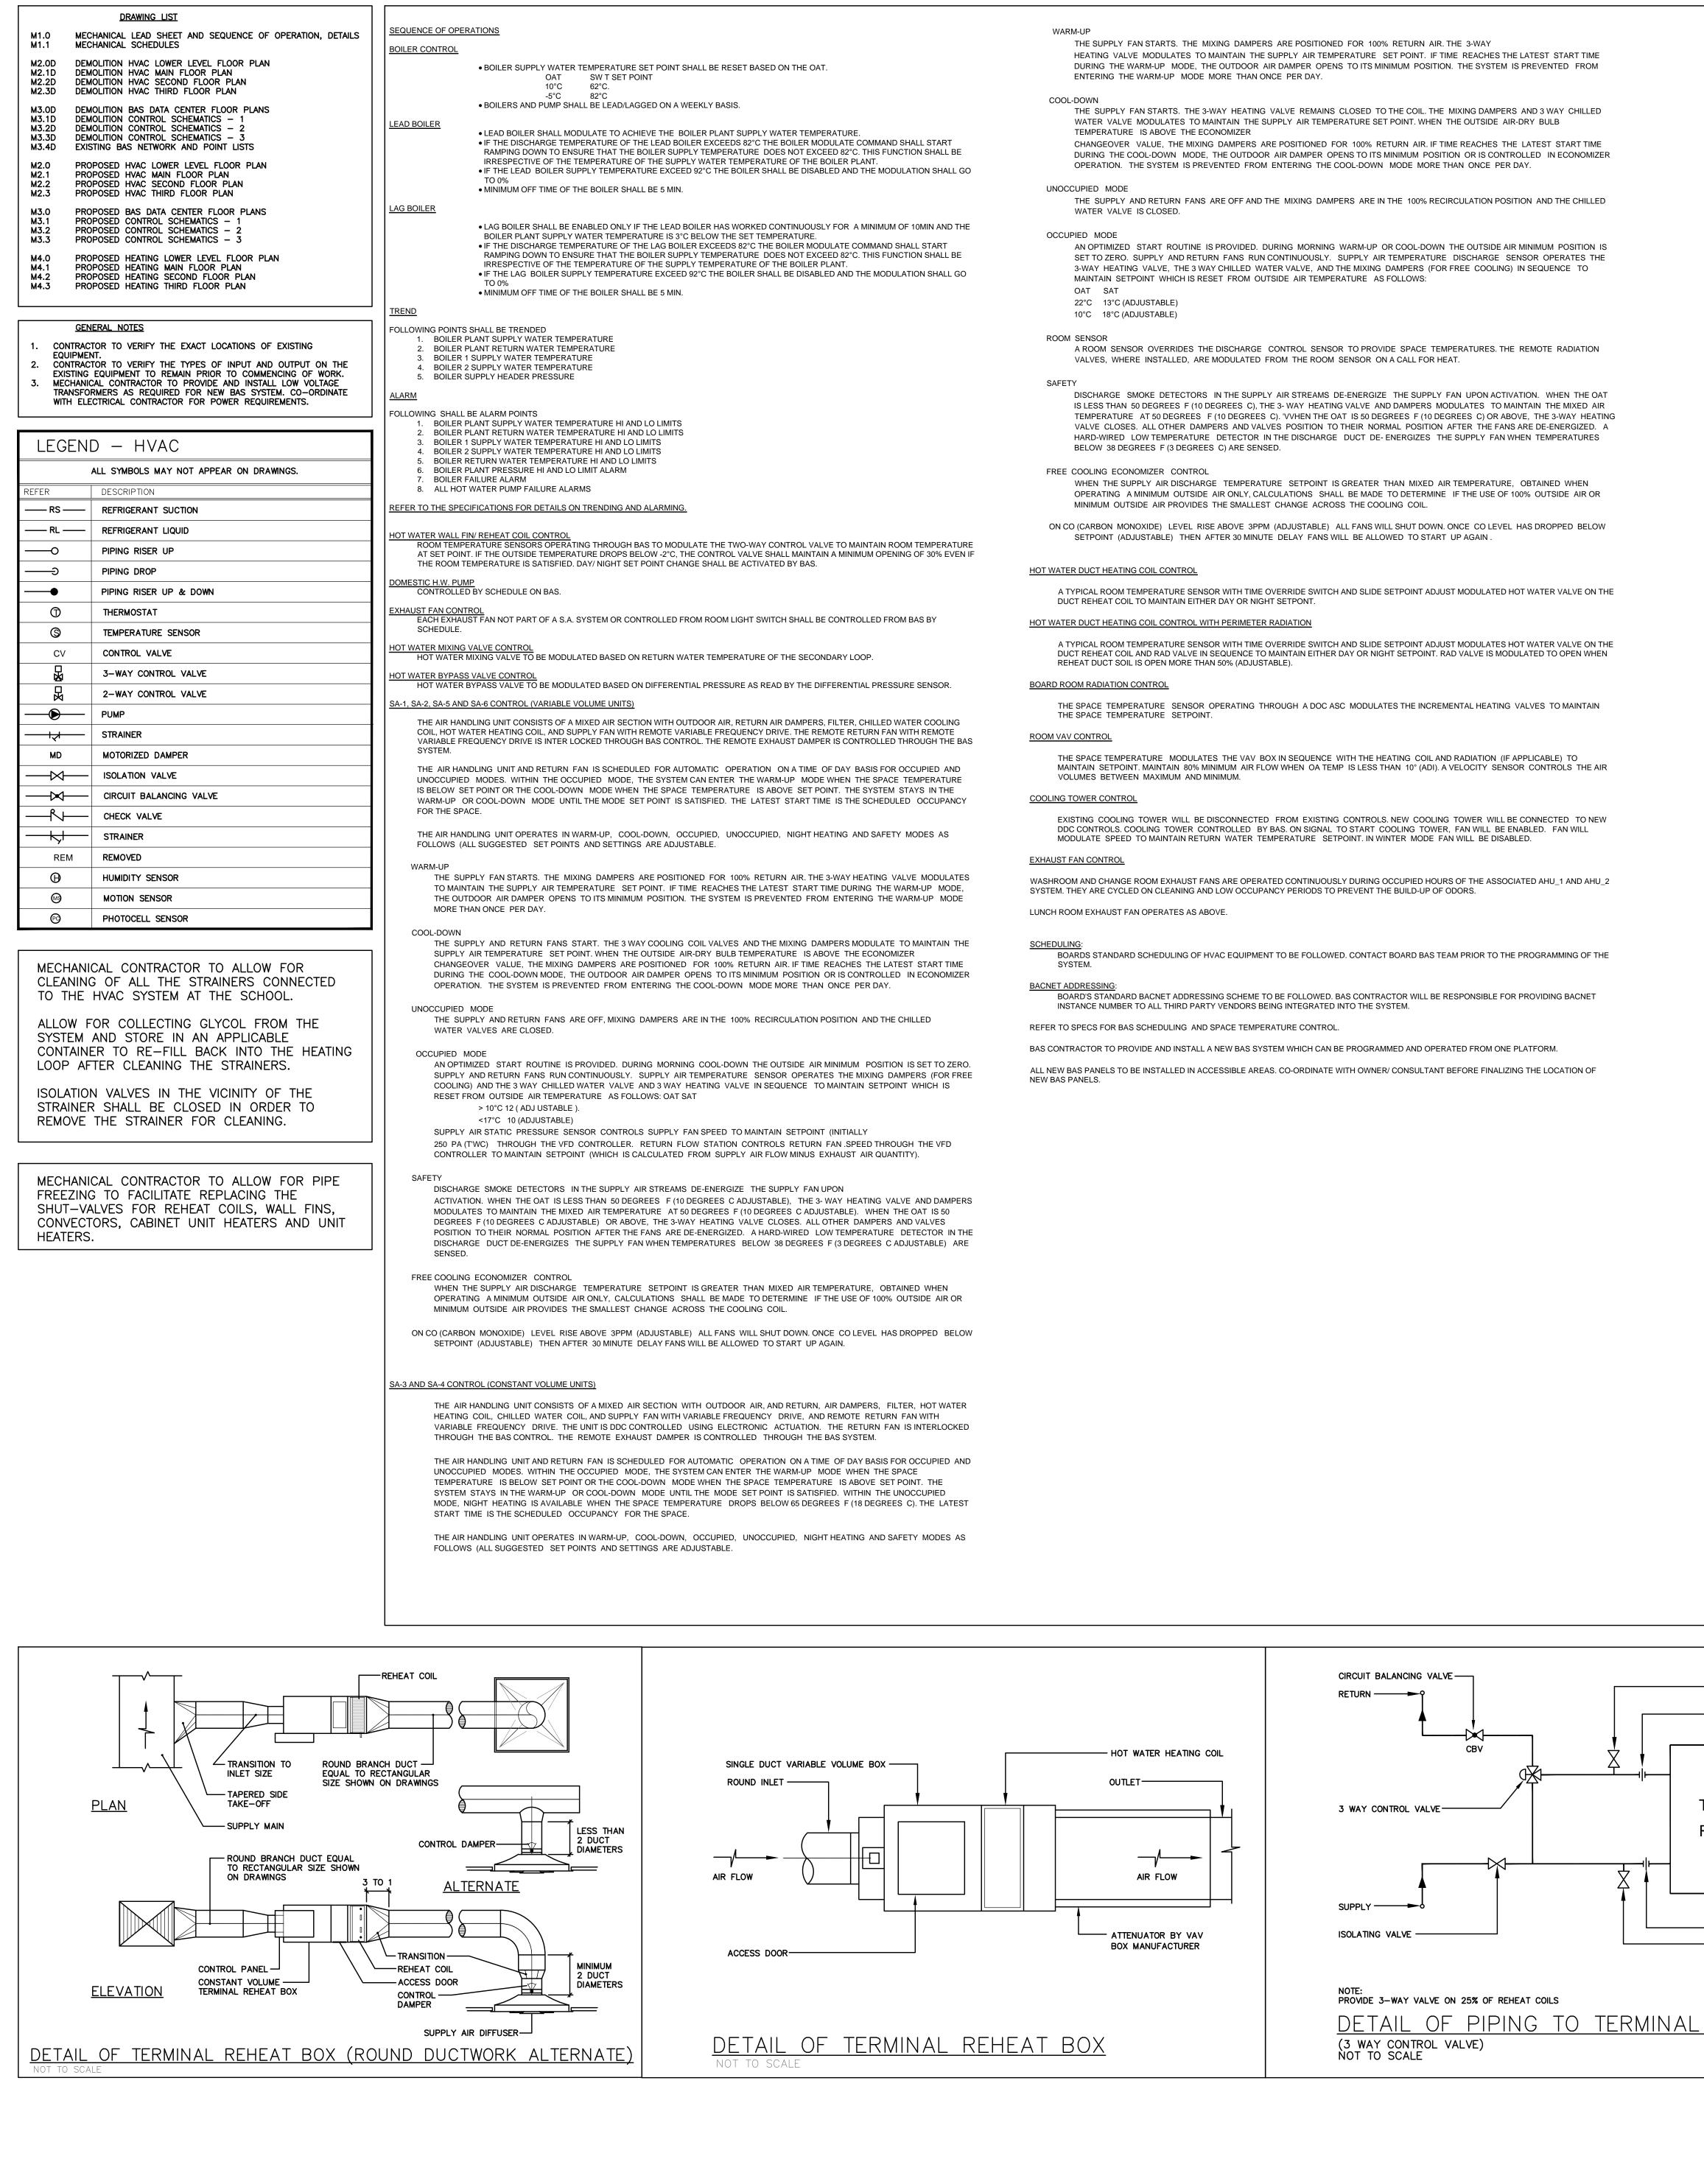


FAN TYPE         1       UTILITY FAN         2       UTILITY FAN         5       UTILITY FAN         6       UTILITY FAN         7       INLINE EXHAUST         5       ROOF EXH. FAN ON         9       ROOF EXH. FAN ON         10       UTILITY FAN         11       UTILITY FAN         12       ROOF EXH. FAN ON         13       ROOF EXH. FAN ON         14       ROOF EXH. FAN ON         15	
2 UTILITY FAN 5 UTILITY FAN 6 UTILITY FAN 7 INLINE EXHAUST 5 ROOF EXH. FAN ON 6 ROOF EXH. FAN ON 9 ROOF EXH. FAN ON 23 INLINE FAN 4 UTILITY FAN 4 UTILITY FAN 4 UTILITY FAN 5 ROOF EXH. FAN ON 5 ROOF EXH. FAN ON 6 ROOF EXH. FAN ON 6 ROOF EXH. FAN ON 7 INLINE FAN 6 ROOF EXH. FAN ON 7 INLINE FAN 6 ROOF EXH. FAN ON 7 INLINE FAN 7 INLIN	
5       UTILITY FAN         6       UTILITY FAN         7       INLINE EXHAUST         5       ROOF EXH. FAN ON         9       ROOF EXH. FAN ON         9       ROOF EXH. FAN ON         23       INLINE FAN         TAN TYPE         UTILITY FAN         INLINE EXHAUST         INLINE FAN ON         INLINE FAN ON         INLINE FAN ON         INLINE FAN ON	
7       INLINE EXHAUST         5       ROOF EXH. FAN ON         6       ROOF EXH. FAN ON         9       ROOF EXH. FAN ON         9       ROOF EXH. FAN ON         23       INLINE FAN         FAN TYPE         UTILITY FAN         INLINE EXHAUST         GOOF EXH. FAN ON         INLINE FAN         NACTOR TO MEASURE TH         RACTOR TO VERIFY THE         INLINE FAN	
5       ROOF EXH. FAN ON         6       ROOF EXH. FAN ON         9       ROOF EXH. FAN ON         9       ROOF EXH. FAN ON         23       INLINE FAN         FAN TYPE         UTILITY FAN         OF EXH. FAN ON         INLINE FAN         INLINE FAN         INLINE FAN         INLINE FAN <td co<="" td=""></td>	
9       ROOF EXH. FAN ON         23       INLINE FAN         FAN TYPE       UTILITY FAN         UTILITY FAN       UTILITY FAN         UTILITY FAN       UTILITY FAN         UTILITY FAN       UTILITY FAN         UTILITY FAN       UTILITY FAN         INLINE EXHAUST       INLINE EXHAUST         6       ROOF EXH. FAN ON         7       ROOF EXH. FAN ON         8       INLINE FAN         7       INLINE FAN         8       INLINE FAN         7       INLINE FAN         7       INLINE FAN         8       INLINE FAN         7       SITE MEASURE TH         7       SITE MEASURE THE         7       SITE MEASURE THE         7       SITE MEASURE THE	
FAN TYPE UTILITY FAN UTILITY FAN INLINE EXHAUST SO ROOF EXH. FAN ON SO ROOF EXH. FAN ON	
UTILITY FAN UTILITY FAN NO ROOF EXH. FAN ON ROOF EXH. FAN ON ROOF EXH. FAN ON NO ROOF EXH. FAN ON NO ROOF EXH. FAN ON NO ROOF EXH. FAN ON ROOF EXH. FAN ON ROOF EXH. FAN ON ROOF EXH. FAN ON ROOF EXH. FAN ON SILINE FAN RACTOR TO MEASURE TH RACTOR TO SUIT THE EXH RACTOR TO VERIFY THE	
UTILITY FAN UTILITY FAN UTILITY FAN UTILITY FAN INLINE EXHAUST ROOF EXH. FAN ON ROOF EXH. FAN ON ROOF EXH. FAN ON ROOF EXH. FAN ON INLINE FAN RACTOR TO MEASURE TH RACTOR TO SUIT THE EXIS RACTOR TO SUIT THE EXIS RACTOR TO VERIFY THE	
ROOF EXH. FAN ON ROOF EXH. FAN ON ROOF EXH. FAN ON NINLINE FAN RACTOR TO MEASURE TH RACTOR TO SITE MEASUR AWINGS TO SUIT THE EXIS RACTOR TO VERIFY THE	
ROOF EXH. FAN ON ROOF EXH. FAN ON INLINE FAN RACTOR TO MEASURE TH RACTOR TO SITE MEASUR AWINGS TO SUIT THE EXIS RACTOR TO VERIFY THE	
ROOF EXH. FAN ON INLINE FAN RACTOR TO MEASURE TH RACTOR TO SITE MEASUR AWINGS TO SUIT THE EXIS RACTOR TO VERIFY THE	
3 INLINE FAN RACTOR TO MEASURE TH RACTOR TO SITE MEASUR AWINGS TO SUIT THE EXIS RACTOR TO VERIFY THE	
RACTOR TO MEASURE TH RACTOR TO SITE MEASUR AWINGS TO SUIT THE EXIS RACTOR TO VERIFY THE	
RACTOR TO MEASURE TH RACTOR TO SITE MEASUR AWINGS TO SUIT THE EXIS RACTOR TO VERIFY THE	
AWINGS TO SUIT THE EXIS RACTOR TO VERIFY THE	


ITROLS	RMARK
-	COOK 165 CPA, COMPLETE WITH PREMIUM EFFICIENCY MOTOR (MIN. 85.5%), DRIVES (1.5SF) © 1386 RPM, DISCONNECT NEMA 1, OSHA BG/WEATHERCOVER-STL, RF-55 SET (6) - ISOLATORS.
_	COOK 120 CPA, COMPLETE WITH DRIVES (1.5SF) @ 1805 RPM, DISCONNECT NEMA 1, OSHA BG/WEATHERCOVER-STL, RF-55 SET (6) - ISOLATORS.
-	COOK 80 CPV (VF), COMPLETE WITH FAN MOUNTED SPEED CONTROL, DISCONNECT NEMA 1, RF-55 SET (6) - ISOLATORS.
-	COOK 120 CPV (VF), COMPLETE WITH FAN MOUNTED SPEED CONTROL, DISCONNECT NEMA 1, RF-55 SET (6) - ISOLATORS.
_	COOK GEMINI GN2000/1PH; COMPLETE WITH DISCONNECT NEMA 1 PRE-WRED, FAN SPEED CONTROLLER 10AMP 240VOLT, RC-75 SET(4) - ISOLATORS.
_	COOK ACED-EC, 70C17DEC; COMPLETE WITH EC MOTOR, FAN MOUNTED SPEED CONTROL, ROOF CURB ADAPTOR, DISCONNECT, BACKDRAFT DAMPER.
_	COOK ACED-EC, 90C17DEC; COMPLETE WITH EC MOTOR, FAN MOUNTED SPEED CONTROL, ROOF CURB ADAPTOR, DISCONNECT, BACKDRAFT DAMPER.
-	COOK ACE-D 165C17D; COMPLETE WITH FAN SPEED CONTROL, PREMIUM EFFICIENCY MOTOR (MIN. 86.5%), REINFORCED WHEEL, ROOF CURB ADAPTOR, DISCONNECT, BACKDRAFT DAMPER
-	COOK 195SQN-B, COMPLETE WITH PREMIUM EFFICIENCY MOTOR (MIN. 86.5%), DRIVES (1.5SF) @ 1141 RPM, DISCONNECT NEMA 1, OSHA BG/WEATHERCOVER-STL, INLET GUARD, RC-125 SET (4) - ISOLATORS.

No.	Completion of the wo	Date
PROJECT :	CATHOLIC EDUCATION CENTRE BAS, VAV, REHEAT COILS & EXHAUST FANS REPLACEMENT PROJECT	40 MATHESON BOULEVARD W., MISSISSAUGA ON
PROFFOO	ONAL SEAL :	
Ure38		
DWG TITLE MEC SHEI	HANICAL L ET, SEQUE RATION, DI	NCE OF
DWG TITLE MEC SHEI OPEI	HANICAL L ET, SEQUE	INCE OF ETAILS
DWG TITLE MEC SHEI OPEI	HANICAL L T, SEQUE RATION, DI CONSULTION UNIT OF THE SECOND OF THE SECO	INCE OF ETAILS
DWG TITLE MEC SHEI OPEI	HANICAL L T, SEQUE RATION, DI CONSULTING ENC UNDECHANICAL & ELECTR Vindsor Drive, Suite 201, Mississa PHONE: (905)855–3010 www.regal-eng.com JUNE 1:75 T BY: M	SINCE OF ETAILS
DWG TITLE MEC SHEI OPEI	HANICAL L T, SEQUE RATION, DI ATION, DI ATION, DI ATION, DI ATION, DI ATION, DI ATION, ALIAN,	INCE OF ETAILS

The Contractor shall verify all dimensions prior

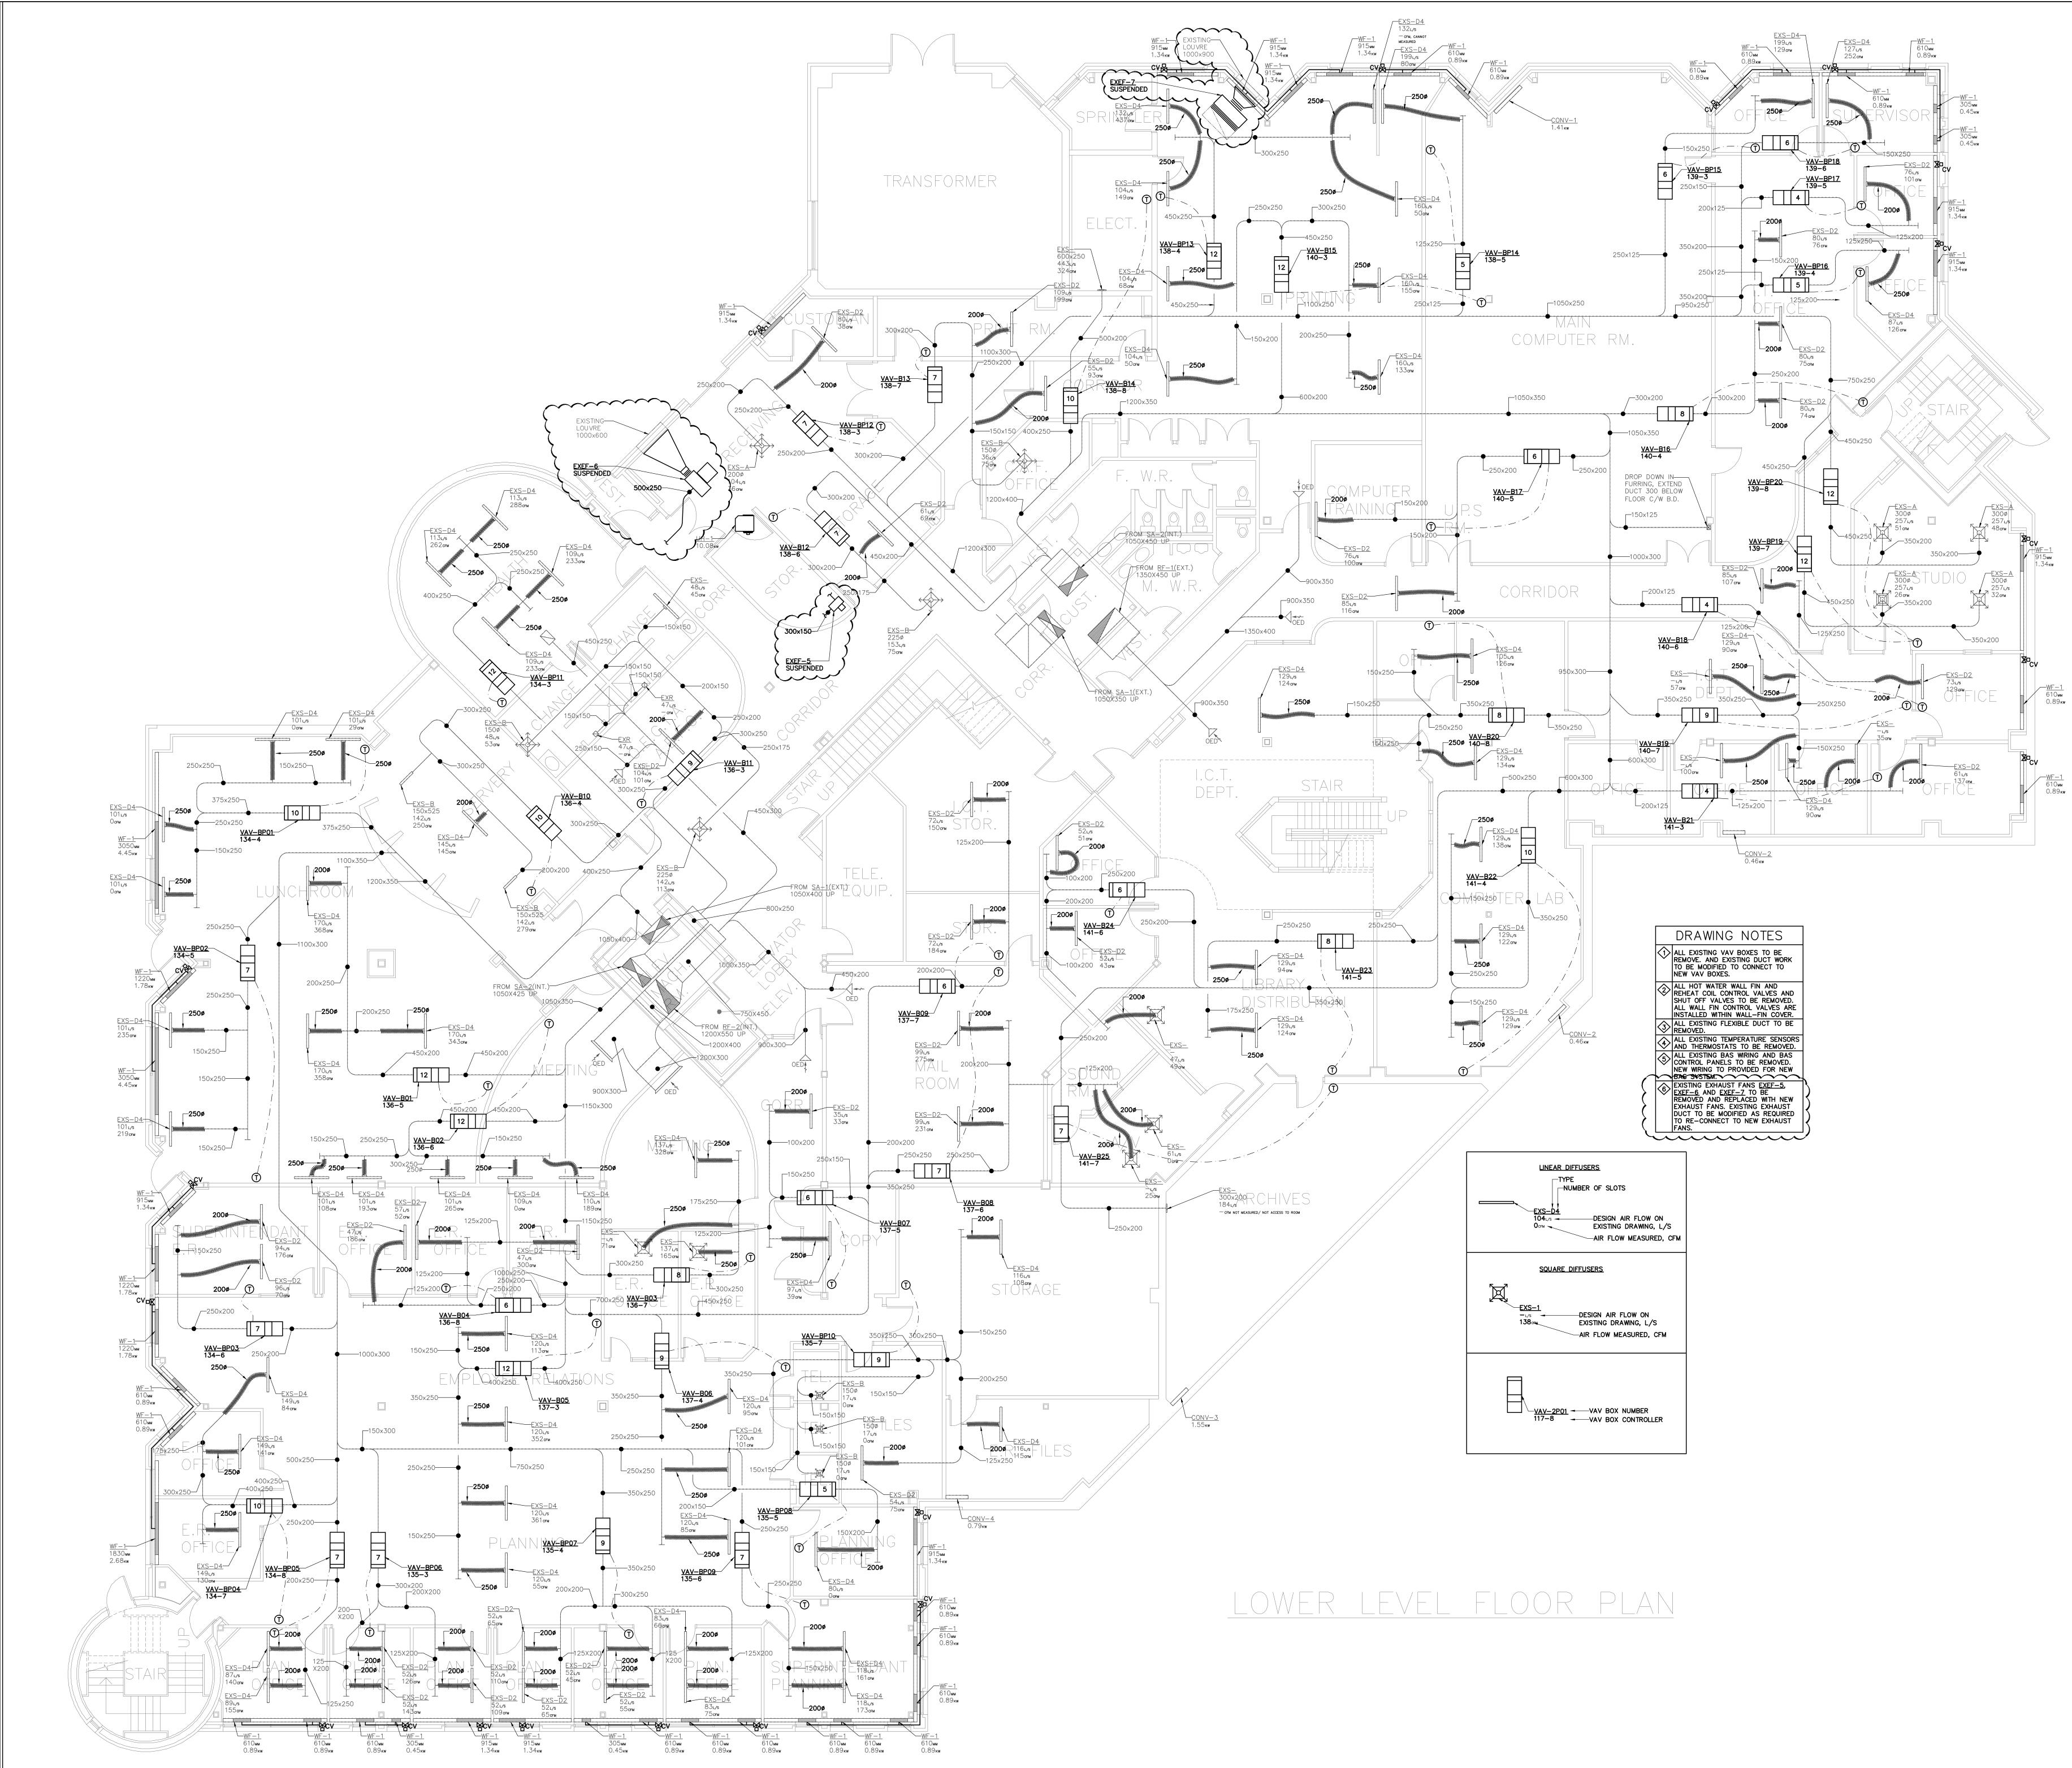

AII	e Contractor shall verify all dimensions prior to commencement of the work. print and specifications are the property of the Architect and must be returned upon completion of the work.
ISS No.	Description Date ISSUED FOR ADDENDUM ME-1 AUG 13, 2021
	· · · · ·
PROJECT :	CATHOLIC EDUCATION CENTRE BAS, VAV, REHEAT COILS & EXHAUST FANS REPLACEMENT PROJECT 40 MATHESON BOULEVARD W., MISSISSAUGA ON
PRO	FESSIONAL SEAL :
D	EMOLITION HVAC OWER LEVEL LOOR PLAN
C	Image: Additional and the second state of the second st
DATE	JUNE 2021
	WN BY: DH
	S STATUS : DESIGN
PRO	JECT No. : 2021-348
	WING No. : 12.0D-A-1

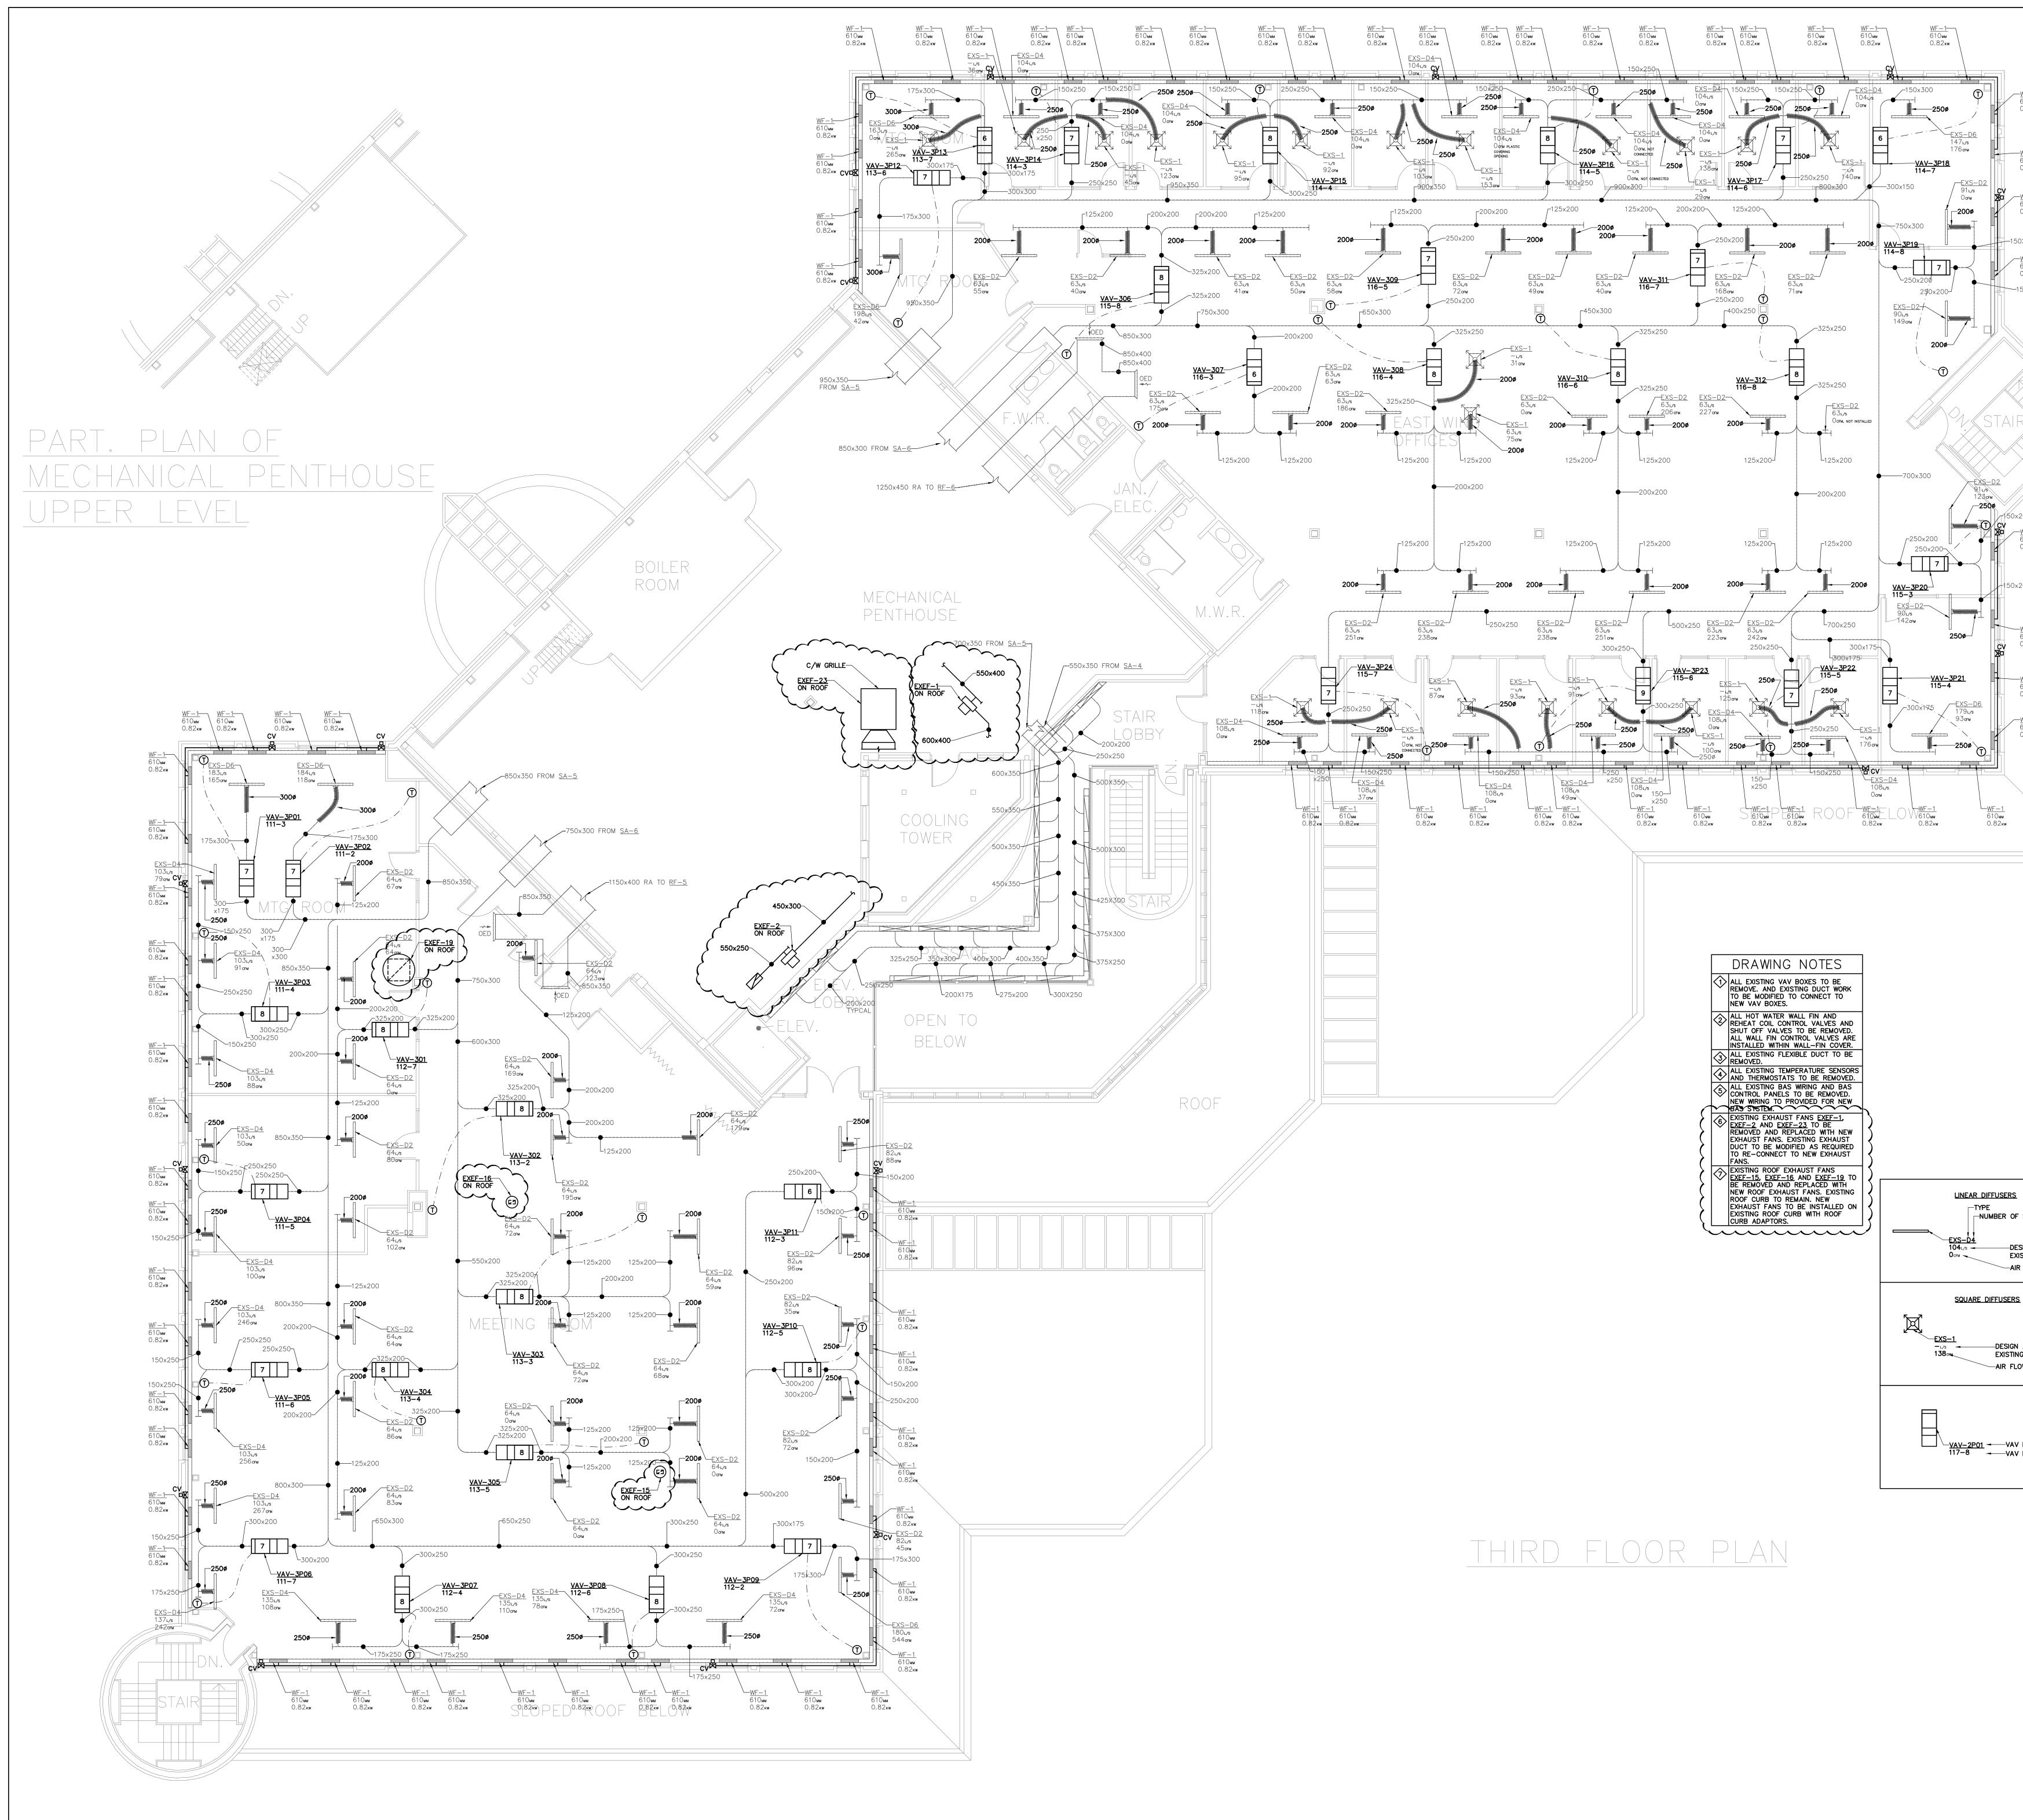

		All pri	ontractor shall verify all dime to commencement of the v nt and specifications are the Architect and must be retur completion of the work	vork. e property of ned upon
<u>VF—1</u> 10мм 0.82кw		ISSU No.	E OR REVISION Description ISSUED FOR TENDER	Date JULY 21, 2021
<u>/F—1</u> 10мм 9.82кw				
<u>VF-1</u> 310 mm 0.82 kw				
X200				
<u>VF—1</u> ;1Омм ).82кw ;0X200			F	
SLOTS		PROJECT :	CATHOLIC EDUCATION CENTRE BAS, VAV, REHEAT COILS & EXHAUST FANS REPLACEMENT PROJECT	40 MATHESON BOULEVARD W., MISSISSAUGA ON
IGN AIR FLOW ON STING DRAWING, L/S FLOW MEASURED, CFM				
AIR FLOW ON 5 DRAWING, L/S W MEASURED, CFM		PROFE	SSIONAL SEAL :	
BOX NUMBER BOX CONTROLLER			TLE : MOLITION H\ IRD FLOOR F	
	1 1:06:28 PM	CONS	1:75 IBY: DH ED BY : MA TATUS : DESIGN	L ENGINEERS a, Ontario L5J 4S9 2021
	Friday, August 13, 2021 1:06:28 PM	drawii M	2021-34 <sup>NG NO.:</sup> <b>2.3D-A-1</b>	REVISION

# **ELECTRICAL SPECIFICATION**

# SCOPE OF WORK

1. SUPPLY LABOUR, TOOLS, SERVICES, EQUIPMENT AND PROVIDE MATERIALS REQUIRED TO COMPLETE WORK IN ACCORDANCE WITH THIS SPECIFICATION AND DRAWINGS. COMPLY WITH LAWS, REGULATIONS AND CODES OF AUTHORITIES HAVING JURISDICTION. CONFORM TO REQUIREMENTS OF BIDDING DOCUMENTS AND DIVISION 1.

# **EXAMINATION OF SITE AND DOCUMENTS**

1. PROVIDE TO SUBMITTING BID, CAREFULLY EXAMINE CONDITIONS AT SITE WHICH WILL OR MAY AFFECT WORK, DRAWINGS AND SPECIFICATION AND BECOME FAMILIAR WITH BUILDING CONSTRUCTION, FINISHES AND OTHER WORK ASSOCIATED WITH WORK IN ORDER THAT BID INCLUDES FOR EVERYTHING NECESSARY FOR COMPLETION OF WORK.

# PERMITS, CERTIFICATES AND FEES

1. PAY FOR AND OBTAIN PERMITS TO COMPLETE WORK. WHEN WORK IS COMPLETE, SUPPLY AND TURN OVER INSPECTION CERTIFICATES FROM GOVERNING AUTHORITIES TO CONSULTANT. PAY FEES AND CHARGES LEVIED BY MUNICIPALITY AND OTHER GOVERNING AUTHORITIES FOR PERMITS. INSPECTIONS AND CERTIFICATES. KEEP COPY OF SUCH PERMITS AND CERTIFICATES, ETC. ON JOB SITE.

#### **CO-ORDINATION AND CO-OPERATION**

- 1. ELECTRICAL CONTRACTOR TO CO-ORDINATE HIS WORK WITH WORK OF ALL TRADES TO ENSURE A PROPER AND COMPLETE INSTALLATION. NOTIFY ALL TRADES CONCERNED OF REQUIREMENT FOR OPENINGS, SLEEVES, INSERTS AND OTHER HARDWARE NECESSARY IN THEIR WORK FOR INSTALLATION OF HIS WORK AND WHERE HIS WORK IS TO BE INTEGRATED WITH WORK OF OTHER TRADES OR IS TO BE INSTALLED IN CLOSE PROXIMITY WITH WORK OF OTHER TRADES. CAREFULLY CO-ORDINATE WORK PRIOR TO AND DRIVING INSTALLATION
- 2. EXACT LOCATIONS AND ROUTING OF SERVICES MUST BE PROPERLY PLANNED CO-ORDIANTED AND ESTABLISHED WITH ALL AFFECTED TRADES PRIOR TO INSTALLATION SUCH THAT THEY WILL CLEAR EACH OTHER AS WILL AS ANY OBSTRUCTIONS. GENERALLY, PIPING REQUIRING UNIFORM PITCH SHALL BE GIVEN RIGHT OF WAY WITH OTHER SERVICE LOCATED AND ARRANGED TO SUIT.

### NOISE CONTROL

1. WORK WHICH MAY CAUSE NOISE DISTURBANCES MUST BE SCHEDULED AT TIMES APPROVED BY CONSULTANT. CO-ORDINATE WORK WITH TPADES TO MINIMIZE NOISE DISTURBANCES.

# CLEAN UP

1. DURING CONSTRUCTION, KEEP SITE REASONABLY CLEAR OF RUBBISH AND WASTE MATERIAL RESULTING FORM WORK ON DAILY BASIS. AFTER COMPLETION OF WORK, REMOVE RUBBISH AND DEBRIS, ARRANGE AND PAY FOR REPAIR OF DAMAGES CAUSED AND LEAVE PREMISES AND WORK IN GOOD ORDER.

#### **PROTECTION OF EQUIPMENT**

1. PROPERLY PROTECT AND STORE ALL EQUIPMENT AND MATERIAL ON SITE FROM DAMAGE CONTRACTOR SHALL BE RESPONSIBLE FOR SAFE STORAGE OF ALL EQUIPMENT AND GOODS TO BE RELOCATED AND SHALL REPAIR OR REPLACE DAMAGED EQUIPMENT AND GOODS AT DISCRETION OF OWNER ..

#### **INSPECTION OF WORK**

- 1. CONSULTANT SHALL AT ALL TIMES HAVE ACCESS TO WORK AND SHALL BE NOTIFIED AT AGREED UPON TIMES OF STAGES OF
- OF WORK HAVE BEEN PERFORMED:
- WHEN 33% OF WORK HAS BEEN COMPLETED:
- WHEN 66% OF WORK HAS BEEN COMPLETED: WHEN 95% OF WORK HAS BEEN COMPLETED:
- UPON SUBSTANTIAL PERFORMANCE OF WORK.
- WHERE STANDARDS OF WORK ARE SPECIFIED OR IMPLIED AND WORK DOES NOT COMPLY WITH PERFORMANCE SPECIFIED OR IMPLIED . SUCH DEFICIENCY SHALL BE CORRECTED AS DIRECTED BY CONSULTANT. ANY SUBSEQUENT TESTING TO VERIFY PERFORMANCE SHALL BE DOWN AT CONTRACTORS/ EXPENSE. AND CHARGE FOR OWNER'S STAFF CONSULTANT OR OTHER PERSONNEL RELATED TO SUCH RE-TESTING SUCH ALSO BE AT EXPENSE OF CONTRACTOR.

### PRODUCTS

1. PRODUCTS LISTED AND/OR SPECIFIED ON CONTRACT DOCUMENTS ARE SELECTED TO ESTABLISH DESIGN STANDARDS. IN MOST CASES, ACCEPTABLE MANUFACTURERS ARE LISTED. BASE YOUR BID PRICE ON BASE SPECIFIED PRODUCTS OR PRODUCTS SUPPLIED FROM ACCEPTABLE MANUFACTURERS. ENSURE PRODUCTS SUPPLIED FROM MANUFACTURERS OTHER THAN BASE SPECIFIED MANUFACTURERS ARE EQUIVALENT TO SPECIFIED PRODUCTS. PROPOSED SUBSTITUTIONS OF MANUFACTURERS OF PRODUCTS MAY BE PROPOSED TO CONSULTANT FOR ACCEPTANCE, LISTING IN EACH CASE CORRESPONDING CREDIT. CONSULTANT HAS SOLE DISCRETION IN ACCEPTING ANY PROPOSED SUBSTITUTION. INCLUDE IN BID PRICE ANY ADDITIONAL PRODUCTS SUPPLY BY MANUFACTURER OTHER THAN BASE SPECIFIED MANUFACTURER.

### WARRANTY

1. WARRANT WORK TO BE IN STRICT ACCORDANCE WITH CONTRACT DOCUMENTS AND FREE FROM DEFECTS FOR 1 YEAR PERIOD FROM DATE OF WRITTEN ACCEPTANCE BY CONSULTANT. REFER AND/OR REPLACE ANY SUCH DEFECTS WHICH APPEAR IN WORK WITHIN WARRANTY PERIOD, ORDINARY WEAR AND EAR AND WILFUL DAMAGE BY, OR CARELESSNESS OF OWNER'S STAFF OR AGENTS EXCEPTED. WITHOUT ADDITIONAL COSTS INCURRED IN MAKING DEFECTIVE WORK GOOD. INCLUDES REPAIR OR REPLACEMENT OF BUILDING FINISHES, OTHER MATERIALS OR DAMAGE TO OTHER EQUIPMENT CAUSED BY SUCH DEFECTS, OR BY SUBSEQUENT REPLACEMENT OR REPAIRS.

# INTERRUPTIONS TO AND SHUTDOWNS OF EXISTING SERVICES AND SYSTEMS

OWNER. OBTAIN WRITTEN APPROVAL IN ADVANCE OF SHUTDOWN OR INTERRUPTION. INCLUDE FOR COSTS OF PREMIUM TIME TO PERFORM WORK DURING NIGHTS. WEEKENDS OR OTHER TIME OUTSIDE OF NORMAL WORKING HOURS. AS NECESSARY TO MAINTAIN SERVICES IN OPERATION OR WITH MINIMUM INTERRUPTIONS AND TO INTERRUPTION WILL BE CARRIED OUT AS CONTINUOUS OPERATION TO MINIMIZE SHUTDOWN TIME AND TO REINSTATE SYSTEMS AS SOON AS POSSIBLE AND PRIOR TO SHUTDOWN. ENSURE MATERIALS AND LABOUR REQUIRED TO COMPLETE WORK FOR WHICH SHUTDOWN IS REQUIRED ARE AVAILABLE AT SITE.

# **CUTTING, PATCHING AND CORE DRILLING**

- AND TRUE FASHION, WITH PROPER TOOLS AND EQUIPMENT TO OWNER'S APPROVAL. 2. IN FIRE RATED CONSTRUCTION PACK AND SEAL VOID BETWEEN OPENING AND CONDUIT FOR LENGTH OF OPENING WITH ASBESTOS-FREE ELASTOMERIC ULC LISTED AND LABELED MATERIALS. INSTALL FIRE-STOP AND SMOKE SEAL MATERIALS IN ACCORDANCE TO ULC CERTIFICATION AND MANUFACTURER'S REQUIREMENTS TO PROVIDE FIRE-STOP RATINGS OF OPENINGS IN
- ACCORDANCE WITH GOVERNING BUILDING CODE REQUIREMENTS. 3. DO NOT CUT OR DRILL EXITING WORK WITHOUT PRIOR OWNER'S APPROVAL. IN CONSULTATION WITH OWNER AND BY USE OF X-RAY WITH OWNER'S APPROVAL, DETERMINE PRESENCE OF EXISTING SERVICES AND PERFORMING ROD CONCEALED BEHIND SURFACE TO BE CUT, NOTE: ELECTRICAL CONTRACTOR WILL BE HELD RESPONSIBLE FOR DAMAGE DONE TO EXISTING BUILDING AND SERVICES CAUSED BY CUTTING OR DRILLING.

### DISCONNECTION, REMOVAL AND RELOCATION

- . WHERE INDICATED ON DRAWINGS AND DETERMINED BY SITE VISIT, DISCONNECT AND REMOVE ITEMS OF EXISTING OBSOLETE ELECTRICAL WORK AND RELOCATE DEVICES, WHERE FIXTURES, SWITCHES, RECEPTACLES AND OTHER DEVICES AND/OR EQUIPMENT IS REMOVED. DISCONNECT AT POINT OF ELECTRICAL SUPPLY, REMOVE OBSOLETE WRING AND MAKE SYSTEM SAFE. WHERE EXISTING OBSOLETE CONDUIT AND SIMILAR RACEWAY MATERIAL CANNOT BE REMOVE. CUT BACK AND CAP OBSOLETE CONDUITS
- OR RACEWAYS. REVISE PANELBOARD DIRECTORIES ACCORDINGLY, IF AFFECTED BY WORK. 2. UNLESS OTHERWISE NOTED, OBSOLETE MATERIALS WHICH ARE DISCONNECTED AND ARE NOT TO BE RELOCATED OR REUSED WILL BECOME THE PROPERTY OF THE ELECTRICAL CONTRACTOR, REMOVE FROM SITE AND DISPOSE. OBTAIN FROM OWNER, LIST OF EXISTING ITEMS TO BE CAREFULLY REMOVED AND TURNED OVER TO OWNER. SAID ITEMS WILL REMAIN PROPERTY OF OWNER.
- 3. PROVIDE JUNCTION BOXES, OUTLET BOXES, WIRING, PLATES, ETC., AS NECESSARY FOR COMPLETE RELOCATION OF DEVICES. CLEAN AND RE-LAMP RELOCATED LUMINARIES. REPLACE FAULTY BALLASTS. WHEN RELOCATION WORK IS COMPLETE, CONFIRM RELOCATED DEVICES ARE IN PROPER ORDER.
- 4. WHERE EXISTING SERVICES PASS THROUGH OR ARE IN AN AREA TO SERVE ITEMS WHICH ARE TO REMAIN, MAINTAIN SERVICES. INCLUDE FOR RE-ROUTING EXISTING SERVICES CONCEALED BEHIND FINISHES AND WHICH BECOME EXPOSED DURING RENOVATION WORK, SO AS TO BE CONCEALED BEHIND FINISHES.
- 5. IN AREAS WHICH ARE NOT BEING RENOVATED AND WHICH DIVISION 16 MUST RUN SERVICES THROUGH, BE RESPONSIBLE FOR REMOVAL AND REINSTALLATION OF ARCHITECTURAL CEILINGS, MECHANICAL EQUIPMENT, SPRINKLERS, ETC., AS REQUIRED FOR INSTALLING OF ELECTRICAL CONTRACTOR'S WORK. PATCH AND MAKE GOOD (INCLUDING PAINTING) SURFACES TO MATCH EXITING.

# HAZARDOUS MATERIALS

1. AT ANY TIME DURING COURSE OF WORK ASBESTOS MATERIALS ARE ENCOUNTERED OR SUSPECTED, CEASE WORK IN AREA IN QUESTION AND IMMEDIATELY REPORT IN ACCORDANCE WITH ONTARIO REGULATION 654/85 (SECTION 7) TO CONSULTANT. DO NOT RESUME WORK IN AFFECTED AREA WITOUT APPROVAL FROM CONSULTANT.

# **RECORD DRAWINGS (AS-BUILTS)**

1. I DRAWINGS FOR THIS PROJECT HAVE BEEN PREPARED ON A CAD SYSTEM. THE SOFTWARE USED IS AUTOCAD RELEASE 2014. COPIES OF DRAWINGS ON DISKS FOR USE IN PREPARING AS-BUILTS, MAY BE REQUESTED FROM THE CONSULTANT. 2. WHEN WORK BEGINS AT SITE, CLEARLY AND ACCURATELY MARK ON A BOUND SET OF WHITE PRINTS OF CONTRACT DRAWINGS ON A DAILY BASIS ALL CHANGES AND DEVIATION FROM ROUTING OF AND LOCATIONS OF EQUIPMENT SHOWN ON CONTRACT DRAWINGS

2. CONTRACTOR SHALL GIVE CONSULTANT TIMELY NOTICE OF DATE (WITHIN 48 HOURS AFTER PERFORMANCE) WHEN FOLLOW STAGES

. CO-ORDINATE AND PERFORM SHUTDOWNS AND INTERRUPTIONS TO EXISTING SYSTEMS AND SERVICES AT TIMES ACCEPTABLE TO

DO CUTTING, PATCHING AND CORE DRILLING OF EXISTING BUILDING REQUIRED FOR INSTALL OF WORK. PERFORM CUTTING TO NEAT 2. BE RESPONSIBLE FOR:

CHANGE AND DEVIATION INCLUDING THOSE MADE BY ADDENDA, CHANGE ORDERS AND SITE INSTRUCTION, AND CHAN DEVIATIONS INDICATED ON SUPPLEMENTAL DRAWINGS ISSUED WITH ADDENDA, CHANCE ORDERS AND SITE INSTRUCTIO "AS-BUILT" WITH PRINTS AT SITE FOR PERIODIC INSPECTION BY CONSULTANT THROUGHOUT DURATION OF WORK. PA PARTICULAR ATTENTION TO ACCURATELY DIMENSIONING LOCATION OF ALL CONCEALED SERVICES TERMINATED FOR FU EXTENSION, ALL BURIED WORK AND SERVICES AND WORK CONCEALED WITHIN BUILDING IN INACCESSIBLE LOCATIONS. 3. WHEN WORK ENDS AT SITE, UPDATE A COPY OF CONTRACT DOCUMENT DRAWING DISC SET SO THAT IT REFLECTS AI FROM ORIGINAL CONTRACT DOCUMENT DRAWIGNS, THUS FORMING A TRUE "AS-BUILT" DRAWING DISC SET. PROVIDE A REPRODUCIBLE MYLAR PRINTS OF CONTRACT DRAWINGS PRODUCED FROM TRUE "AS-BUILT" MYLAR PRINTS TO CONS

SUBMITTED DRAWINGS SHALL BE OF THE SAME QUALITY AS ORIGINAL CONTRACT DOCUMENT DRAWINGS. 4. UPDATE OWNER'S DISTRIBUTION RISER DIAGRAMS POSTED IN ELECTRICAL ROOM.

# **GENERAL CONDUIT AND CONDUCTOR INSTALLATION REQUIREMENTS**

1. INSTALL CONDUIT AND CONDUCTORS CONCEALED TO DEGREE MADE POSSIBLE BY FINISHES AND PROVED INSTALLATION ACCORDANCE WITH ELECTRICAL SAFETY CODE AND LOCAL GOVERNING AUTHORITIES. PLAN AND CO-ORDINATE LOCAT ROUTING OF SERVICES WITH TRADES PRIOR TO INSTALLATION. IN AREAS WHERE A MULTIPLICITY OF SERVICES OCCUR DETAIL DRAWINGS AND SUBMIT TO CONSULTANT FOR REVIEW PRIOR TO START OF AFFECTED WORK. 2. WHERE CONDUIT AND/OR CONDUCTORS ARE EXPOSED, ARRANGE SAME TO AVOID INTERFERENCE WITH OTHER WORK PARALLEL TO BUILDING LINES. WHERE HORIZONTAL CONDUITS AND/OR CONDUCTORS ARE EXPOSED, INSTALL AS HIGH POSSIBLE. DO NOT INSTALL CONDUIT AND/OR CONDUCTORS WITHIN 6" (150MM) OF 'HOT' PIPES OR EQUIPMENT UNLE AND/OR CONDUCTORS ARE ASSOCIATED WITH EQUIPMENT. INDEPENDENTLY RUN CONDUIT AND CONDUCTORS MUST BE FROM THE CEILING OR WALL STRUCTURE, NOT FROM CEILING HANGERS, DUCTWORK, PIPING, CABLE TRAYS ETC. 3. IDENTIFY CONDUIT RUNS (IE. TAG BOTH ENDS OF CONDUIT RUNS)

# CONDUITS

- 1. I PROVIDE CONDUIT FOR CONDUCTORS. CONDUIT TO BE EMT (THIN WALL) GALVANIZED, ELECTICAL METALLIC TUBING NO. 83, COMPLETE WITH FACTORY MADE BENDS WHERE SITE BENDING IS NOT POSSIBLE AND JOINTS AND TERMINATI WITH SET SCREW TYPE CONNECTORS, FOR SHORT BRANCH CIRCUIT CONNECTORS TO MOTORIZED EQUIPMENT AND TRA (MINIMUM LENGTH 18" (450MM), MAXIMUM LENGTH 24" (600MM) WITH 180 DEGREE LOOP WERE POSSIBLE)-GALVANIZ FLEXIBLE FLUID - TIGHT METALLIC CONDUIT TO CSA C222 NOT. 56, COMPLETE WITH IDEAL 'STEEL TOUGH' LIQUID TH CONDUIT CONNECTORS AT TERMINATIONS. FOR CONDUIT GREATER THAN 2" (1200MM), PROVIDE RIGID GALVANIZED S" C222 NO. 45 COMPLETE WITH FITTINGS, CONNECTORS AND RIGID COUPLINGS.)
- 2. SUPPORT AND SECURE CONDUIT AT SPACING IN ACCORDANCE WITH CODE REQUIREMENTS BY MEANS OF GALVANIZED STRAPS, CONDUIT CLIPS, RING BOLT TYPE HANGERS OR BY OTHER PROPER MANUFACTURER DEVICES. PROVIDE CONI CONSTRUCTED OF SAME MATERIALS AS CONDUIT AND SUITABLE FOR APPLICATION. SQUARE AND PROPERLY REAM EI CUT CONDUIT. GENERALLY CONDUIT IS SIZED ON DRAWINGS. SIZE CONDUIT NOT SIZED ON DRAWING IN ACCORDANCE BEND CONDUIT AT FULL CONDUIT DIAMETER WITH NO KINKS AND N OOFLAKING R CRACKING OF FINISHES.

# CONDUCTORS

- ALL CONDUCTORS SHALL BE COPPER UNLESS INDICATED OTHERWISE
- 2. CONDUCTORS #10 AWG AND SMALLER SHALL BE SOLID. CONDUCTORS #8 AND LARGER SHALL BE STRANDED 3. CONDUCTORS SHALL BE SIZED #12 AWG MINIMUM, EXCEPT FOR CONTROL CIRCUITS WHERE #14 AWG MINIMUM SIZE IS FEEDER SIZES AS INDICATED.
- 4. SIZE CONDUCTORS FOR A 2% MAXIMUM VOLTAGE DROP FROM OVERCURRENT DEVICE TO FARTHEST OUTLET. CONDUCTOR INSULATION RATED FOR 600V MINIMUM UNLESS STATED OTHERWISE.
- 6. CONDUCTOR TYPES:
- 6.1 TW75, TWU TO C.S.A. #C22.2 NO. 75 6.2 RW90, RWU90 (XLPE) TO C.S.A. #C22.2 NO. 38
- 6.3 TW75, RW90 (XLPE) INSIDE BUILDING.
- 6.4 TWU, RWU90 (XLPE) CONDUCTORS DIRECT BURIED OR IN CONDUIT OUTSIDE BUILDING. 6.5 BX (ARMOURED CABLE) IS ONLY PERMITTED FOR LIGHT FIXTURE DROPS IN ACCOUSTIC CEILINGS (MAX LENGTI

# **OUTLET BOXES, PULL BOXES AND JUNCTION BOXES**

- 1. PROVIDE CSA APPROVED STAMPED GALVANIZED STEEL OUTLET BOX FOR EACH LUMINARIES, FIRE ALARM DEVICE, ETC DRAWINGS FOR LOCATIONS OF OUTLETS. CONFIRM EXACT LOCATIONS PRIOR TO ROUGH-IN. 2. PROVIDE PULL BOXES AND JUNCTION BOXES WHEREVER NECESSARY TO FACILITATE CONDUCTOR & CONDUIT INSTALL GENERALLY, PROVIDE CONDUIT RUNS EXCEEDING 100' (30M) IN LENGTH OR WITH MORE THAN 3, 90 DEGREE BENDS BOX INSTALLED AT CONVENIENT AND SUITABLE INTERMEDIATE ACCESSIBLE LOCATION. PROVIDE JUNCTION BOXES AND SIZED IN ACCORDANCE WITH CODE TO SUIT NUMBER AND SIZE OF CONDUITS AND CONDUCTORS. BOXES TO BE GALL PRIME COATED PLATED STEEL COMPLETE WITH SCREW-ONN OR HINGED COVERS AND KNOCKOUTS. BOXES MUST BE AFTER WORK IS COMPLETE.
- 3. .SIZE, ARRANGEMENT AND TYPE OF BOXES MUST BE SUITABLE FOR APPLICATION. PROVIDE BLANK COVER PLATES O OBSOLETE BOXES WHICH ARE TO REMAIN. CLEARLY IDENTIFY MAIN PULL OR JUNCTION BOXES BY SPRAY PAINTING ( ACCORDANCE WITH FOLLOWING COLOUR SCHEDULE:
- 3.1 LIGHTING YELLOW 3.2 NORMAL POWER - BLUE
- 3.3 ESSENTIAL POWER ORANGE
- 3.4 FIRE ALARM RED 4. WHERE REQUIRED, SUPPLY ACCESS DOORS OF MINIMUM NO. 23 GAUGE, PRIME COATED STEEL COMPLETE WITH HINGE FRAMES TO GIVE ACCESS TO BOXES AND CONDUCTOR JOINTS AND OTHER SIMILAR ELECTRICAL WORK WHICH MAY NE MAINTENANCE OR REPAIR, BUT WHICH IS CONCEALED IN IN ACCESSIBLE CONSTRUCTION. CONFIRM FINISHES WITH OW

# FASTENING AND SECURING HARDWARE

1. PROVIDE PROPER FASTENERS AND SIMILAR HARDWARE REQUIRED FOR CONDUIT CONDUCTORS AND FOR EQUIPMENT H AND/OR SUPPORT MATERIAL UNLESS OTHERWISE NOTED. EXPLOSIVE POWER ACTUATED FASTENERS WILL NOT BE PER UNLESS SPECIFIC WRITTEN APPROVAL FOR US AND TYPE HAS BEEN OBTAINED FROM CONSULTANT. UNDER NO CIRCL US CEILING SUSPENSION HANGERS OR GRIDS FOR SUSPENSION OF CONDUIT AND CONDUCTORS.

# **IDENTIFICATION NAMEPLATES**

1. FOR EACH PIECE OF ELECTRICAL DISTRIBUTION EQUIPMENT FROM ELECTRICAL SOURCE OF SUPPLY UP TO AND INCLU PLANELOADS, PROVIDE ENGRAVED LAMACOID IDENTIFICATION NAMEPLATES SECURED TO APPARATUS WITH.

# ELECTRICAL CONNECTIONS FOR MECHANICALS, OWNER'S ETC., EQUIPMENT

- PROVIDE REQUIRED ELECTRICAL CONNECTIONS TO APPARATUS SUPPLIED BY DIVISION 15. OWNER AND AS PART OF ( DIVISIONS. DO REQUIRED ELECTRICAL WORK FOR EQUIPMENT SCHEDULED ON DRAWINGS. DIVISION 15 WILL SUPPLY STA MOTORIZED APPARATUS SUPPLIED BY THEM AND WILL PROVIDE LAMACOID IDENTIFICATION THROUGHOUT.
- 2.1 COMPLETE INSTALLATION AND CONNECTION OF STARTERS AND PROVIDE 'LINE' AND 'LOAD' POWER CONNECTION INTERLOCKING AS REQUIRED.
- 2.2 PROVIDE MOTOR STARTER PANELS CONSISTING OF NO. 14 GAUGE STEEL BOLTED PANELS SIZED TO ACCOMMO STARTERS AS REQUIRED AND SUITABLE SPLITTER. 2.3 UNLESS OTHERWISE NOTED OR SHOWN ON DRAWINGS, MOUNT 1-PHASE STARTERS ADJACENT TO EQUIPMENT
- AND CONNECT COMPLETE. 2.4 CO-ORDINATE FEEDER ENTRIES TO STARTERS AND STARTER ASSEMBLIES WITH DIVISION 15. 2.5 PROVIDE ADDITIONAL DISCONNECT SWITCHES (COMPLETE WITH IDENTIFICATION DETAILED ON DRAWINGS, REQUIRI
- OR FOR APPARATUS WHICH CANNOT BE SEEN FROM ITS STARTER OR IS IN EXCESS OF 30' (9M) FROM IT STARTER) 2.6 DO INTERLOCK WIRING INDICATED ON DRAWINGS AND /OR SCHEDULES.
- 2.7 CONNECT REQUIRED CIRCUITS TO MOTOR STARTER PANEL SO AS TO BALANCE ACTUAL LOADS (WATTAGE).


# **GENERAL ELECTICAL WORK TESTING**

IN ADDITION TO TESTS REQUIRED BY GOVERNING AUTHORITIES AND REGULATIONS, TEST WORK TO ENSURE THERE AR GROUNDS OR CROSSES. ENSURE DEVICES ARE COMMISSIONED AND OPERABLE. COONECT CIRCUITS TO PANEL BOARDS BALANCE ACTUAL LOADS (WATTAGE) WITHIN 5%. IF REQUIRED TRANSPOSE CIRCUITS WHEN WORK IS COMPLETE TO MI REQUIREMENT.

# **CODES AND STANDARDS:**


- 1. DO COMPLETE INSTALLATION IN ACCORDANCE WITH C.S.A C22.1 EXCEPT WHERE SPECIFIED OTHERWISE 1.2 COMPLY WITH C.S.A. ELECTRICAL BULLETINS IN FORCE AT TIME OF TENDER SUBMISSION, WHILE NOT IDENTIFIED SPECIFIED BY NUMBER IN THIS DIVISION, ARE TO BE CONSIDERED AS FORMING PART OF RELATED C.S.A. PART
- STANDARD. 1.3 DO OVERHEAD AND UNDERGROUND SYSTEMS IN ACCORDANCE WITH C.S.A. C22.3 NO. 1 EXCEPT WHERE SPECIF OTHERWISE.
- 1.4 ABBREVIATIONS FOR ELECTRICAL TERMS: TO C.S.A. Z85.
- 1.5 COMPLY ALSO WITH THE FOLLOWING CODES: ONTARIO ELECTRICAL SAFETY CODE
  - NATIONAL BUILDING CODE .4 ONTARIO BUILDING CODE

	All p	Contractor shall verify to commencemen rint and specification le Architect and must	t of the wor s are the pr	rk. roperty of
		completion of	the work.	
GES AND NS. MAINTAIN	ISSL	JE OR REVISION	1	
Y JTURE	No. 1.	Description Issued For Addendu	m ME-1	Date 13/08/2021
L DEVIATIONS				
SET OF SULTANT. ALL				
NS IN				
IONS AND IS, PREPARE		⊢		
AND		& EXHAUST		
I AS ESS CONDUIT		IAL		
E SUPPORTED		X		
		Ш		
O CSA C222 DNS MADE		COILS		
ANSFORMERS ED STEEL		Ö		
GHT FLEXIBLE		O I		
EEL TO CSA		AT		
PIPE UIT FITTINGS		· 뿌		
UIT FITTINGS IDS OF SITE WITH CODE.		Ξ	⊲	•
		Ω.	Ю	)
		BAS, VAV, REHEA	AL	
		1	Ś	) )
PERMITTED.		Ś		<u>/</u> )
		3A	Ś	)
			Σ	
		R C	3	
ł 5'-0")		ЫN		j
		ШQ	A R	
. REFER TO		N C C C C C C C C C C C C C C C C C C C		
				]
WITH PULL PULL BOYES			or O	)
ATIONS. WITH PULL PULL BOXES ANIZED OR ACCESSIBLE		ĭZ C∕	ñ	)
		CE CE	Z	
N EXISTING OVERS IN		ΡĒ	S	)
		<u> </u>		
		CATHOLIC EDUCATION CENTRE FANS REPLACEMENT PROJECT	MATHESON BOULEVARD W. MISSISSAUGA	
S AND ED	 ⊢	S – S	Ň	
IER.	PROJECT	A A N A	400	
	РК	ЧС	4(	-
ANGER MITTED	PROFI	ESSIONAL SEAL :		
MSTANCES				
DING				
THER ARTERS FOR	DWG 1	TITLE :		
		SPEC	S	
S AND			0	
ATE				
HEY SERVE				
D BY CODE,				
		RC	EL/	
E NO LEAKS,	RFG	AL CONSULTING	ENGINE	FRS INC.
S SO AS TO EET THIS	CON	NSULTING MECHANICAL & E oyal Windsor Drive, Suite 201,	ELECTRICAL El Mississauga, O	NGINEERS
		PHONE: (905)8 www.regal-er	55-3010 ng.com	
	DATE			<u> </u>
AND II		A	UG 20	21
IED	SCALE	 ∃:		
	DRAW	/N BY:	НН	
		KED BY :		
		וע שבו .	MA	
	DWG S		=\^/	
		REVI	_ V V	
	PROJE	ECT No. : 2021	1-348	3
				1
				REVISION
	I E	1.0		

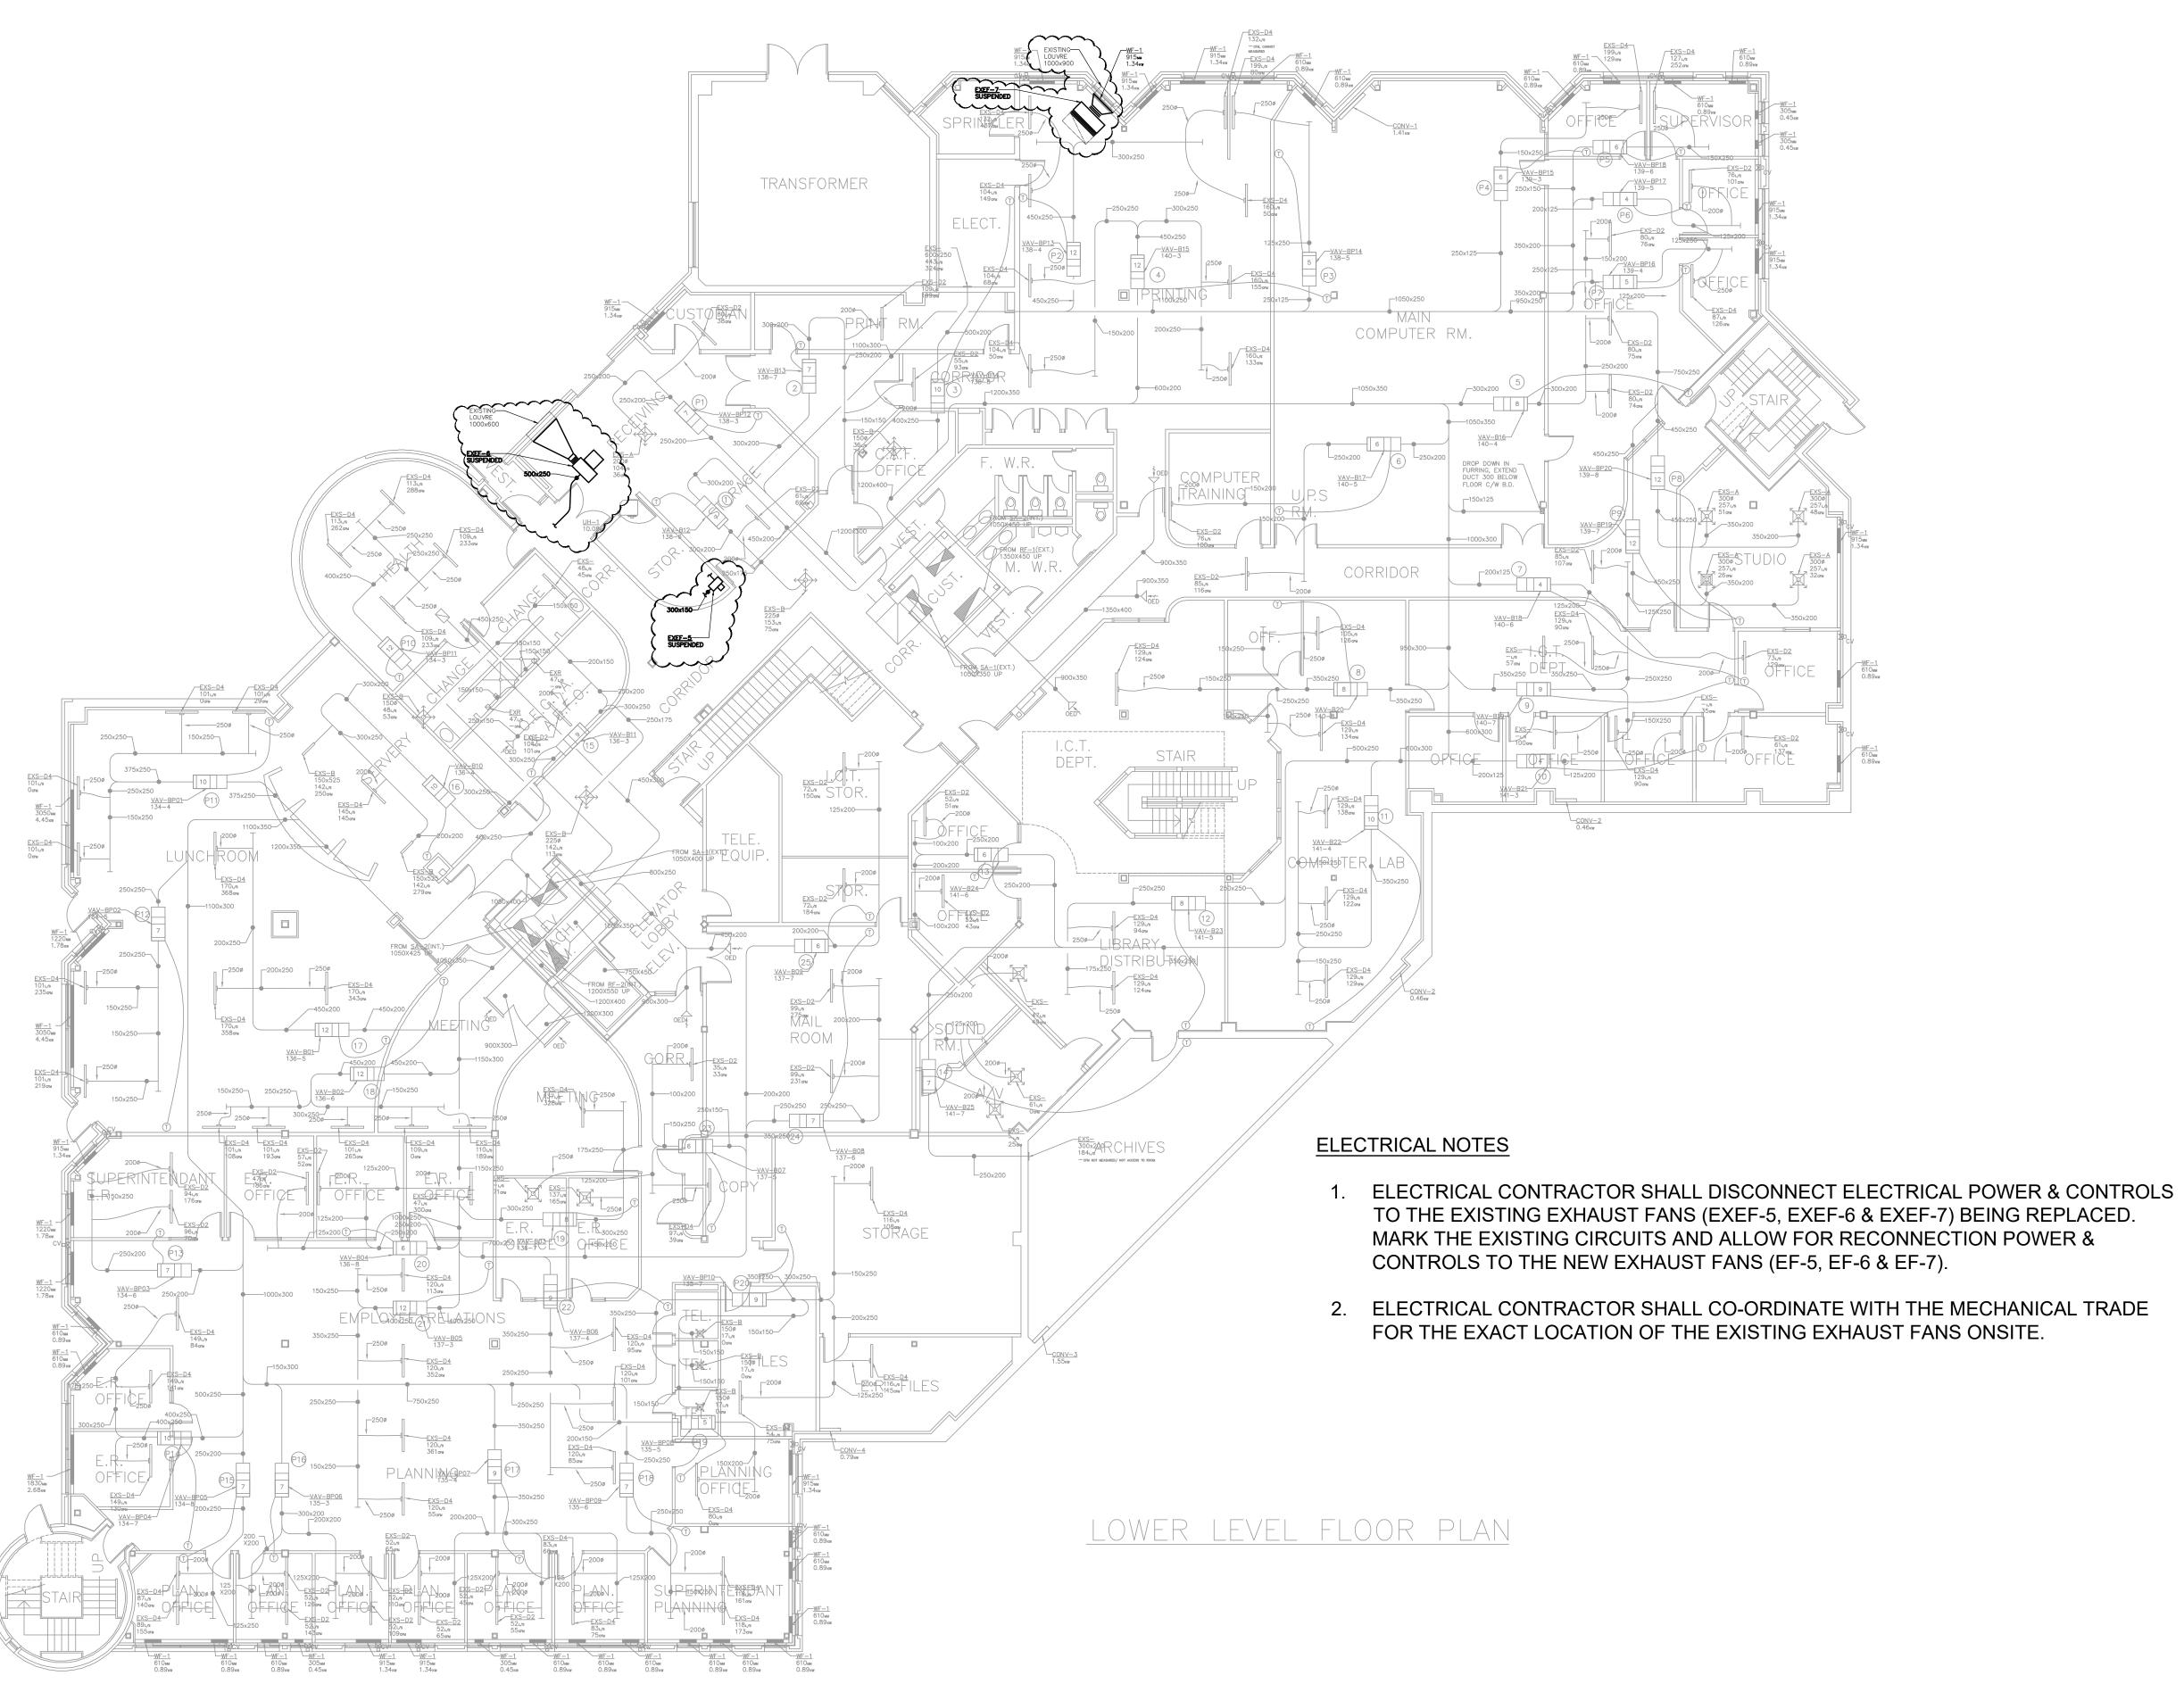

TO THE EXISTING EXHAUST FANS (EXEF-5, EXEF-6 & EXEF-7) BEING REPLACED.

All	Contractor shall veri to commenceme print and specificatio he Architect and mus completion o	ent of the wor ons are the pr st be returned	k. operty of
ISS No. 1.	UE OR REVISIO Descriptior Issued For Addend	n	Date 13/08/2021
PROJECT :	CATHOLIC EDUCATION CENTRE BAS, VAV, REHEAT COILS & EXHAUST FANS REPLACEMENT PROJECT	400 MATHESON BOULEVARD W. MISSISSAUGA	
DWG	AL CONSULTING NSULTING MECHANICAL & Royal Windsor Drive, Suite 20 PHONE: (905	EL FLO	
CHEC	www.regal- E : NN BY: CKED BY : STATUS : DES	AUG 202 1:125 DH MA	

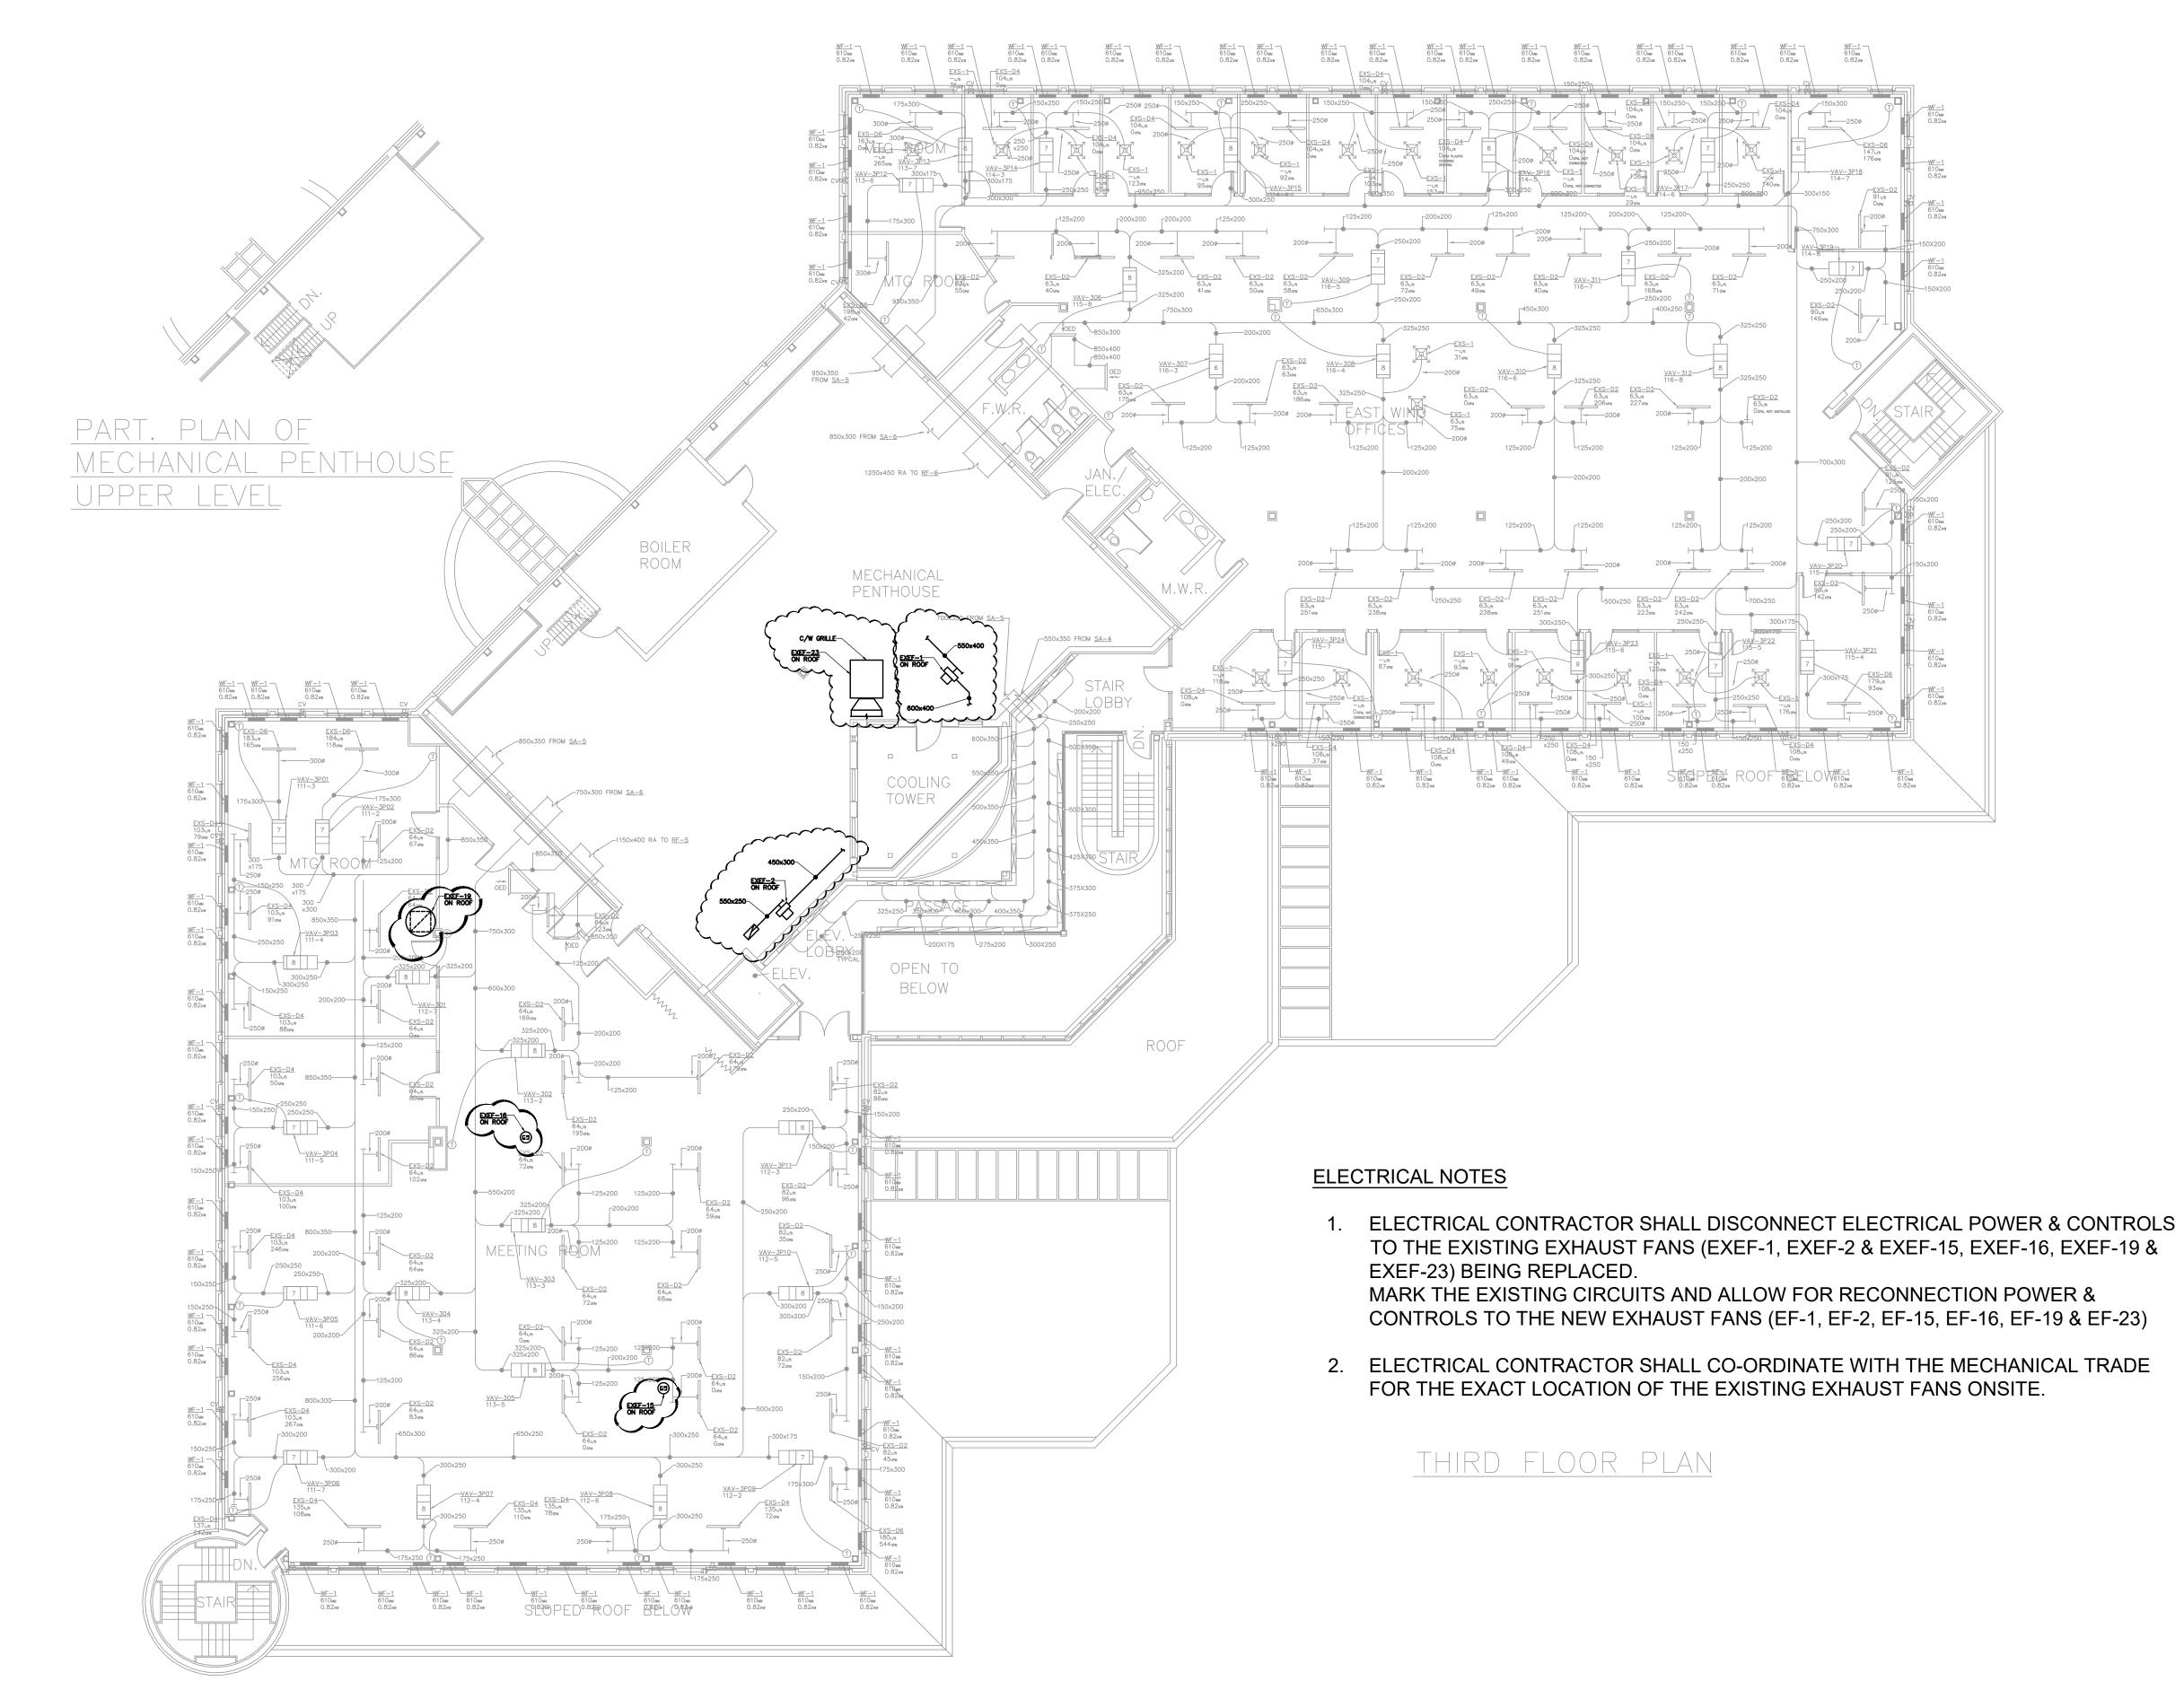

No.		of the work.	
1.			Date
	Issued For Adden	dum ME-1 1	3/08/202
PROJECT :	CATHOLIC EDUCATION CENTRE BAS, VAV, REHEAT COILS & EXHAUST FANS REPLACEMENT PROJECT	400 MATHESON BOULEVARD W, MISSISSAUGA	
	EMOLITIC	_	
11			
CONSL	CONSULTIN ULTING MECHANICAL Windsor Drive, Suite 2 PHONE: (90 www.regal	& ELECTRICAL ENG 01, Mississauga, Onta 5)855-3010	INEERS
CONSL 2359 Roya DATE : SCALE :	CONSULTIN JLTING MECHANICAL Windsor Drive, Suite 2 PHONE: (90 www.regal	G ENGINEER & ELECTRICAL ENG 01, Mississauga, Onta 5)855-3010	INEERS rio L5J 45
CONSL 2359 Roya DATE :	CONSULTIN JUTING MECHANICAL Windsor Drive, Suite 2 PHONE: (90 www.regal	G ENGINEER & ELECTRICAL ENG 01, Mississauga, Onta 5)855-3010 -eng.com AUG 2022 1:125 DH	INEERS rio L5J 45
CONSL 2359 Roya DATE : SCALE : DRAWN I	D BY :	G ENGINEER & ELECTRICAL ENG 01, Mississauga, Onta 5)855-3010 -eng.com AUG 202 1:125	INEERS rio L5J 45
CONSL 2359 Roya DATE : SCALE : DRAWN I CHECKE	D BY :	AUG 202 1:125 DH MA	INEERS rio L5J 45
CONSL 2359 Roya DATE : SCALE : DRAWN I CHECKE	DBY : DBY : DIST : DIST : DIST : DIST : DIST : DIST : DIST	AUG 202 1:125 DH MA	INEERS rio L5J 45